


Mary Savio Medical Plaza Aiea Pearl City
ENGINEER'S CERTIFICATION
(Second Amendment to Condominium Map)

The undersigned, ATHER DAR, being first duly sworn on oath, deposes and says:

1. I am a registered professional engineer (Registration No. 7808-S) in the State of Hawaii.
2. I am the responsible engineer for preparing the Condominium Map (the "Condominium Map") for Mary Savio Medical Plaza Aiea Pearl City (formerly known as Mary Savio Medical Plaza at Newtown), a condominium project (the "Project") situated on land located at 98-1247 Kaahumanu Street, Aiea, Oahu, Hawaii 96701, further identified by Tax Map Key No. (1) 9-8-008-026. The Condominium Map was recorded in the Bureau of Conveyances of the State of Hawaii as Map No. 5117 and in the Office of the Assistant Registrar of the Land Court of the State of Hawaii as Map No. 2174, and is amended to insert Sheets A-2A, A-2B, A-2C, A-2D, A-2E, A-2F, A-9A, A-10A, A-13A, and A-13B, dated May 10, 2017 (the "Revised Sheets").
3. I certify that, to the best of my knowledge, the Revised Sheets depict the layout, location, dimensions and numbers of the units in the Project substantially as built.


Dated: May 18, 2017

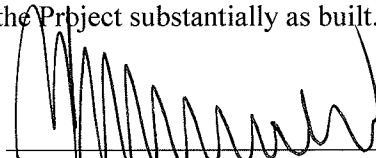

 ATHER DAR

STATE OF HAWAII)
) SS.
 CITY AND COUNTY OF HONOLULU)

On this 18th day of May, 2017, before me personally appeared ATHER DAR, to me satisfactorily proven to be the person described in and who executed the foregoing instrument and acknowledged to me that such person executed the same as the free act and deed of such person.

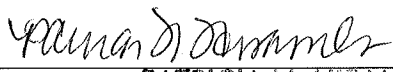

 Print Name: **PATRICIA N. HISAMOTO**
 Notary Public for above-noted State and County
 My Commission expires: MARCH 27 2020


15

Document Date: May 18, 2017 Number of Pages: 1
 Notary Name: PATRICIA N. HISAMOTO First Judicial Circuit
 Document Description: MARY SAVIO MEDICAL PLAZA AIEA
PEARL CITY ENGINEER'S CERTIFICATION (SECOND AMENDMENT
TO CONDOMINIUM MAP)

 MAY 18 2017 15

 Notary Signature Date

NOTARY CERTIFICATION

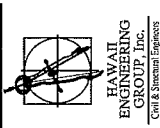


PROJECT: MARY SAVIO MEDICAL PLAZA AT NEWTOWN
 98-1247 KAHUMANU STREET
 AEA, HAWAII 96701
 T.M.K.: 9-8-008-026
 SHEET TITLE: EXISTING GROUND LEVEL PLAN
 ISSUANCE/REVISIONS:


Date: 05/10/17
 Scale: AS NOTED
 Drawn By: K.J. AQ
 Design By: AD
 Checked By: AD
 Job: 16-162
 Sheet: A-2A
 1 of 10 Sheets

GROUND FLOOR PARKING STALLS			
STANDARD	ADA	COMPACT	TOTAL
100	4	0	104

TOTAL PARKING	
DESCRIPTION	STALLS
REGULAR PARKING STALL:	393 STALLS
COMPACT PARKING STALL:	4 STALLS
HANDICAP PARKING STALL:	17 STALLS
TOTAL PARKING STALL:	414 STALLS
LOADING STALL:	6 STALLS

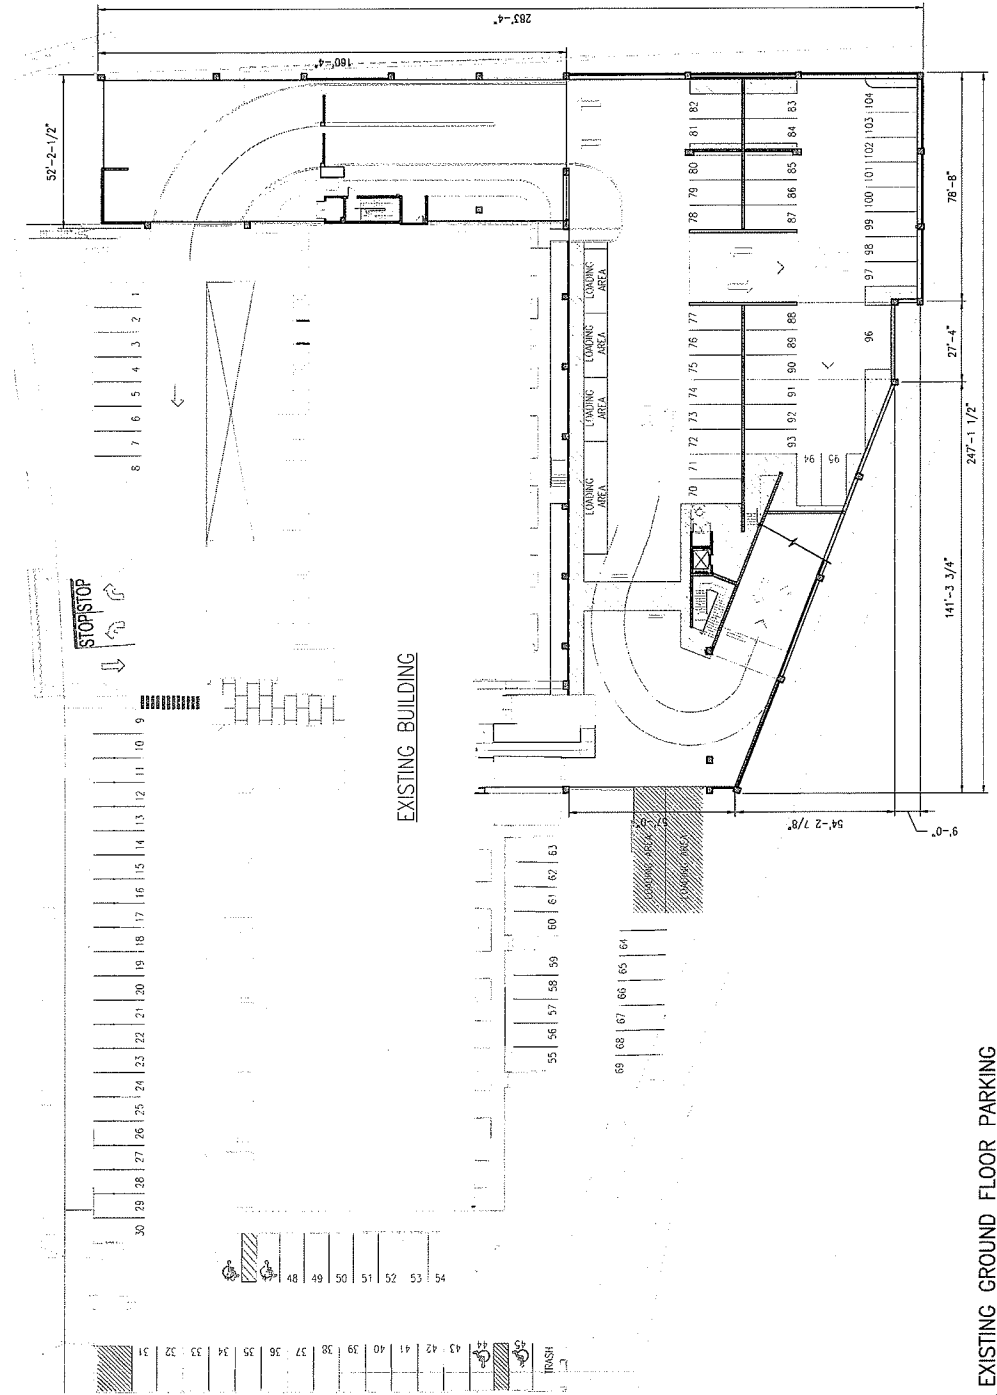


1 EXISTING GROUND FLOOR PARKING
 A-2A SCALE: 1/8"=1'-0"

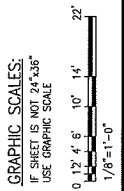


P1A & P2 PARKING STALLS			
STANDARD	ADA	COMPACT	TOTAL
46	11	1	58

TOTAL PARKING	
DESCRIPTION	STALLS
REGULAR PARKING STALL:	383 STALLS
COMPACT PARKING STALL:	4 STALLS
HANDICAP PARKING STALL:	17 STALLS
TOTAL PARKING STALL:	414 STALLS
LOADING STALL:	6 STALLS

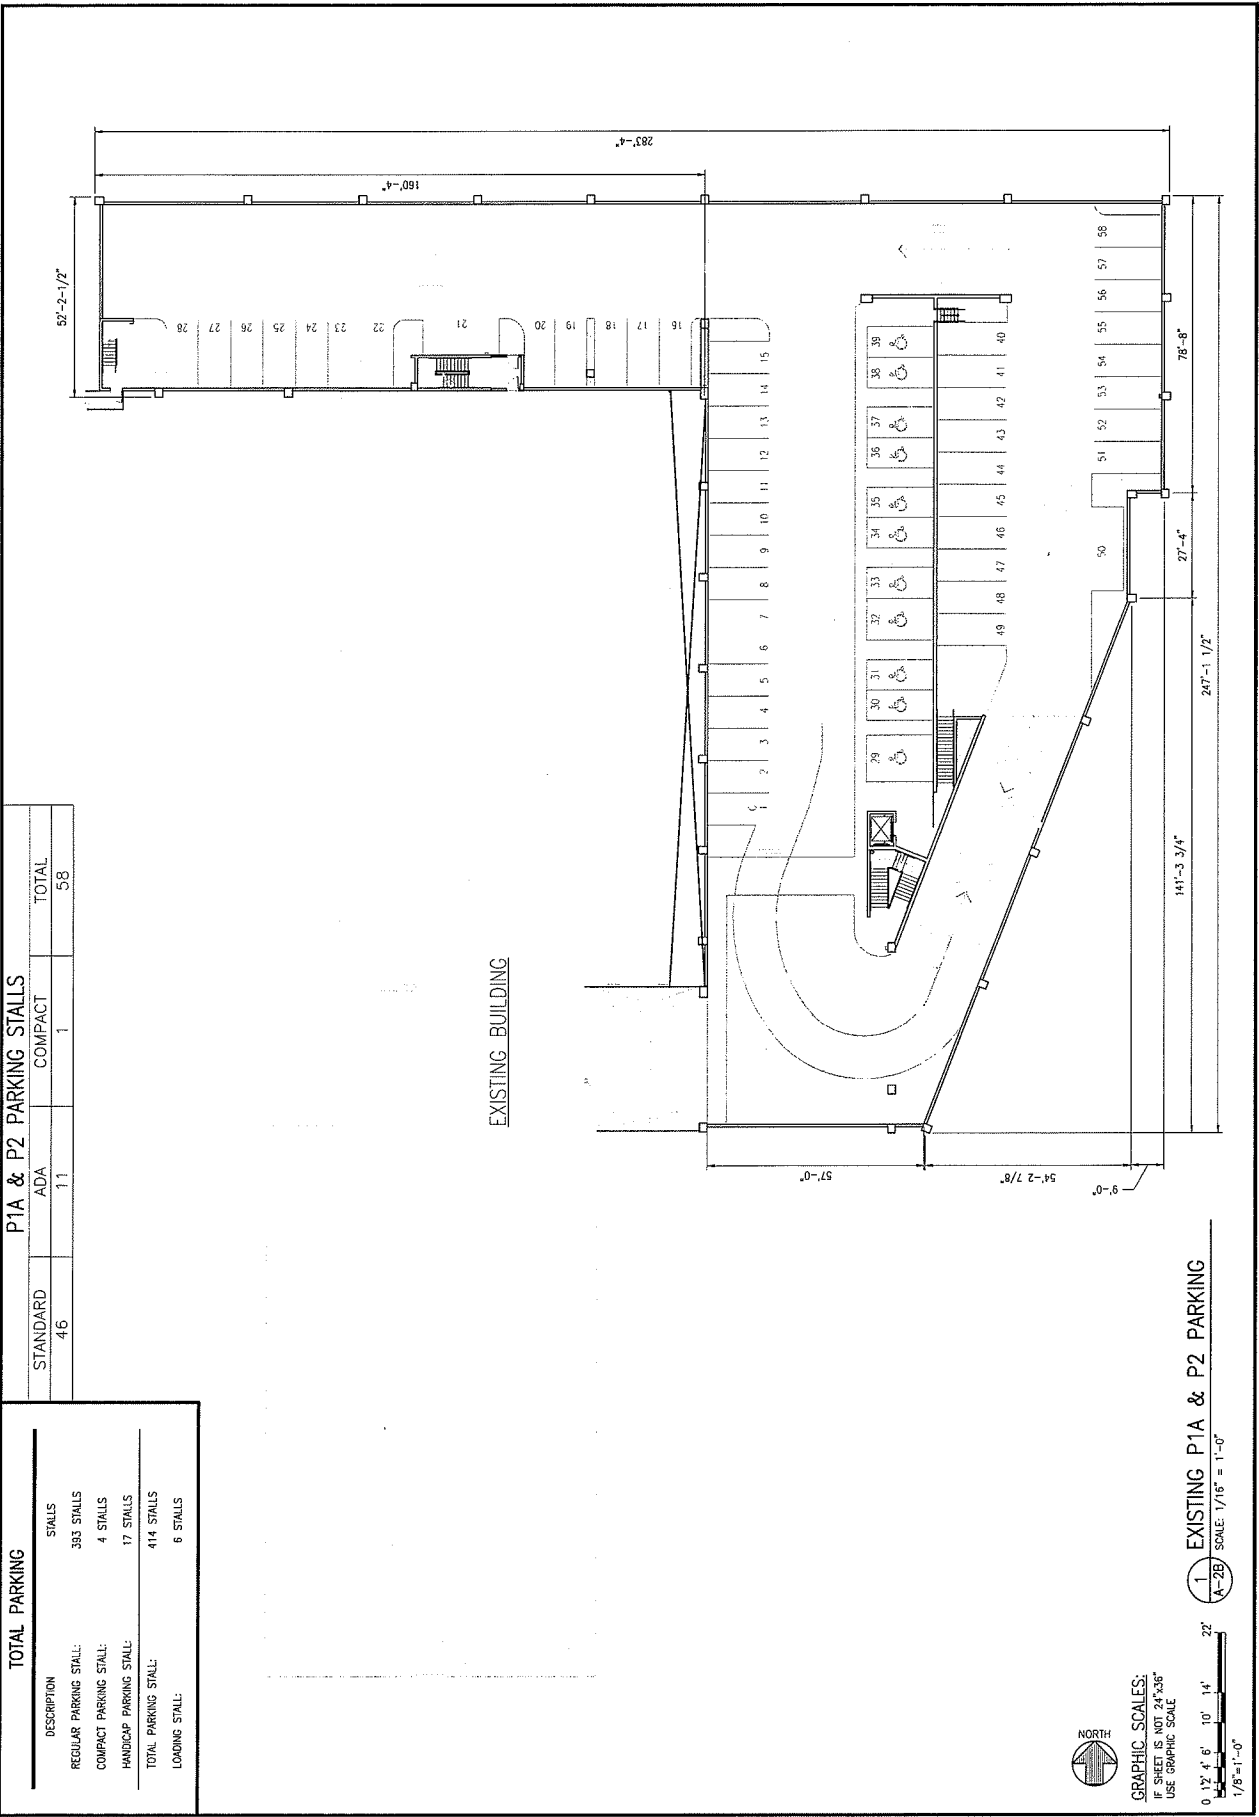

HAWAII ENGINEERING GROUP, Inc.
Civil & Structural Engineers

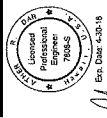

En. Date: 4-30-16
THIS PROJECT WAS APPROVED BY ME OR UNDER MY SUPERVISION AND I AM A REGISTERED PROFESSIONAL ENGINEER IN THE STATE OF HAWAII. I WILL BE UNDER MY REGISTRATION.

MARY SAVIO MEDICAL PLAZA AT NEWTOWN
CONDOMINIUM MAP
98-1247 KAAHUMANU STREET
AIEA, HAWAII 96701

T.M.K. : 9-8-008:026
PROJECT:
SHEET TITLE:
EXISTING P1A & P2
FLOOR PLAN

ISSUANCE/REVISIONS
Date: 05/10/17
Scale: AS NOTED
Drawn by: KJ, AQ
Design By: AD
Checked By: AD
Job: 16-162

Sheet **A-2B**
2 OF 10 Sheets



1 EXISTING P1A & P2 PARKING
A-2B SCALE: 1/16" = 1'-0"



GRAPHIC SCALES:
IF SHEET IS NOT 24"x36"
USE GRAPHIC SCALE



03/2015 P:\Projects\15-182 Mary Savio Medical Plaza (2015) at NewTown\GIS Through\15-182 Mary Savio Medical Plaza.dwg
Monday, May 1, 2017 12:04 PM

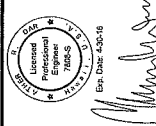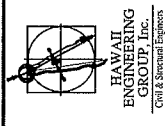

THIS PROJECT WAS PREPARED BY ME OR UNDER MY SUPERVISION AND I AM A LICENSED PROFESSIONAL ENGINEER. IT WILL BE UNDER MY JURISDICTION.

PROJECT: MARY SAVIO MEDICAL PLAZA AT NEWTOWN
 98-1247 KAHUIMANU STREET
 AIEA, HAWAII 96701
 T.M.K.: 9-8-008-026


SUBJECT TITLE: EXISTING P2A & P3 FLOOR PLAN

ISSUANCE/REVISIONS:
 Date: 05/10/17
 Scale: AS NOTED
 Drawn By: Kd, AQ
 Design By: AD
 Checked By: AD
 Job: 15-162

Sheet: A-2C
 3 OF 10 SHEETS

FLOOR	STANDARD	ADA	COMPACT	TOTAL
P2A-P3	58	2	1	61


TOTAL PARKING	
DESCRIPTION	STALLS
REGULAR PARKING STALL:	393 STALLS
COMPACT PARKING STALL:	4 STALLS
HANDICAP PARKING STALL:	17 STALLS
TOTAL PARKING STALL:	414 STALLS
LOADING STALL:	6 STALLS

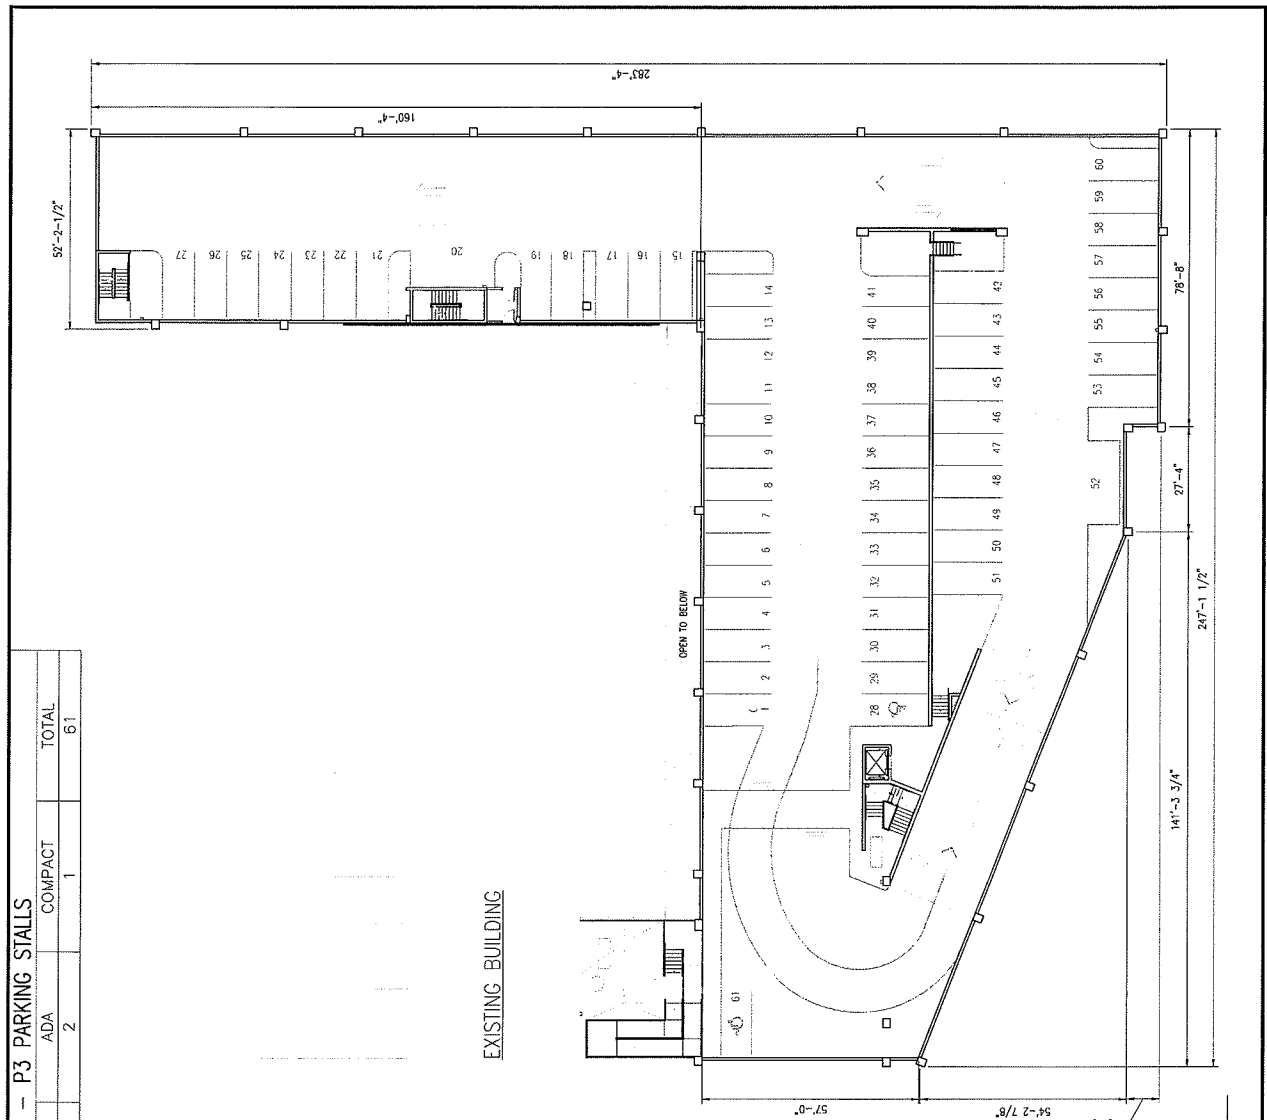


1 EXISTING P2A & P3 FLOOR PLAN
 SCALE: 1/16" = 1'-0"



GRAPHIC SCALES:
 IF SHEET IS NOT 24"x36"
 USE GRAPHIC SCALE

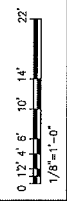

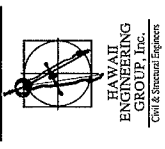

HAWAII ENGINEERING GROUP, Inc.
 Civil & Structural Engineers
 License No. 7282-S
 Exp. Date: 4-30-18
 THE PROJECT WAS PREPARED BY ME OR UNDER MY SUPERVISION AND I AM A LICENSED PROFESSIONAL ENGINEER. I WILL BE UNDER MY OBSERVATION.

PROJECT: MARY SAVIO MEDICAL PLAZA AT NEWTOWN
 98-1247 KAAHUMANU STREET
 AIEA, HAWAII 96701
 T.M.K.: 9-8-008.026
 SHEET TITLE: EXISTING P3A & P4 FLOOR PLAN


ISSUANCE/REVISIONS
 Date: 05/10/17
 Scale: AS NOTED
 Drawn By: KJ, AD
 Design By: AD
 Checked By: AD
 Job: 16-162
 Sheet: A-2D
 4 of 10 Sheets

P3A - P4 PARKING STALLS

FLOOR	STANDARD	ADA	COMPACT	TOTAL
P3A-P4	58	0	1	59

TOTAL PARKING

DESCRIPTION	STALLS
REGULAR PARKING STALL:	394 STALLS
COMPACT PARKING STALL:	4 STALLS
HANDICAP PARKING STALL:	16 STALLS
TOTAL PARKING STALL:	414 STALLS
LOADING STALL:	6 STALLS

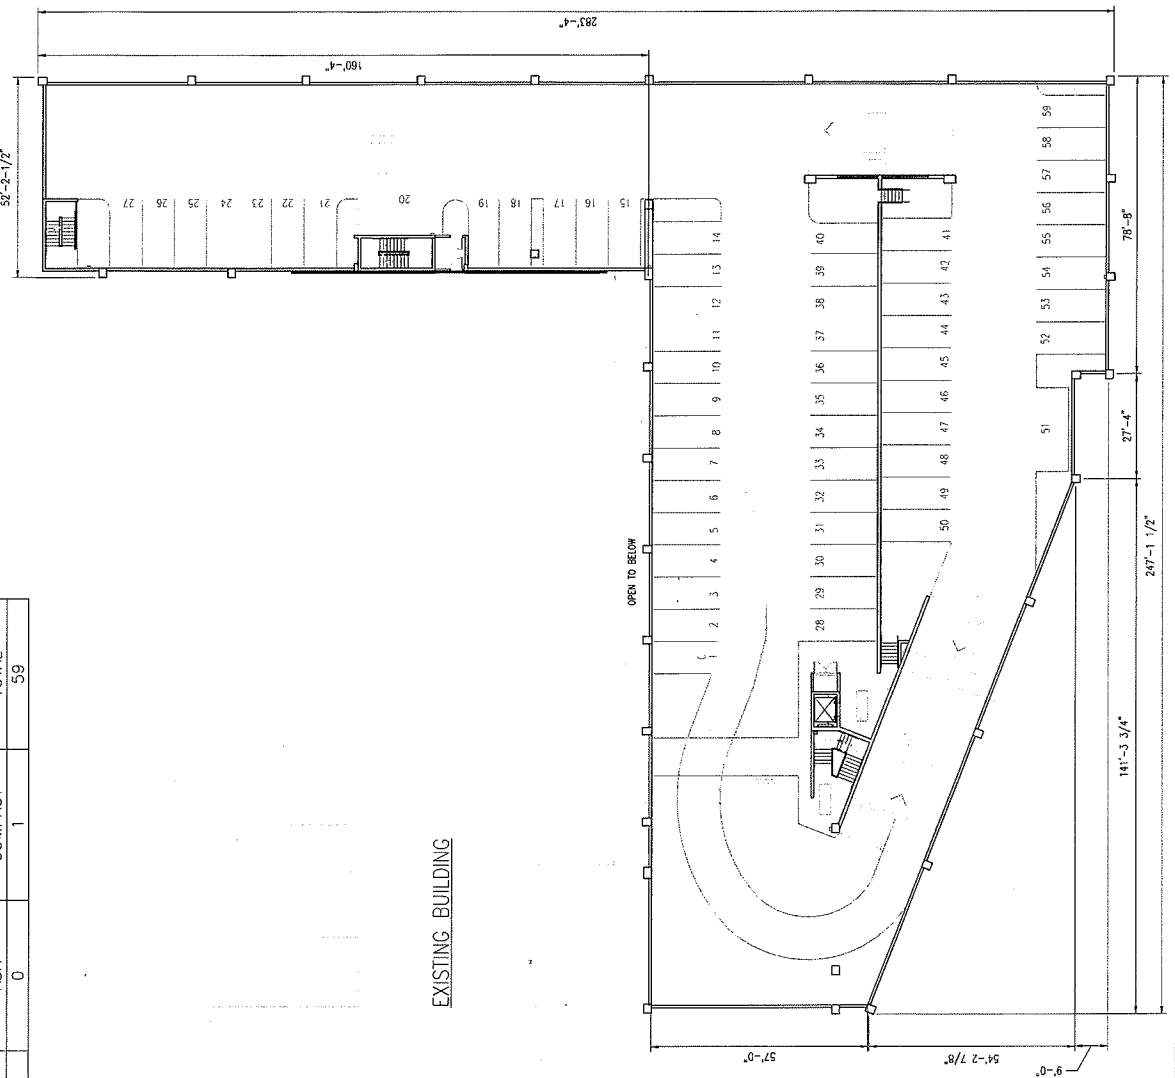


GRAPHIC SCALES:
 IF SHEET IS NOT 24"x36"
 USE GRAPHIC SCALE
 0' 17' 4' 8' 10' 14'
 1/8"=1'-0"

1 EXISTING P3A & P4 FLOOR PLAN
 A-2D SCALE: 1/16" = 1'-0"

P4A - P5 PARKING STALLS				
FLOOR	STANDARD	ADA	COMPACT	TOTAL
P4A-P5	59	0	1	60

TOTAL PARKING	
DESCRIPTION	STALLS
REGULAR PARKING STALL:	394 STALLS
COMPACT PARKING STALL:	4 STALLS
HANDICAP PARKING STALL:	16 STALLS
TOTAL PARKING STALL:	414 STALLS
LOADING STALL:	6 STALLS

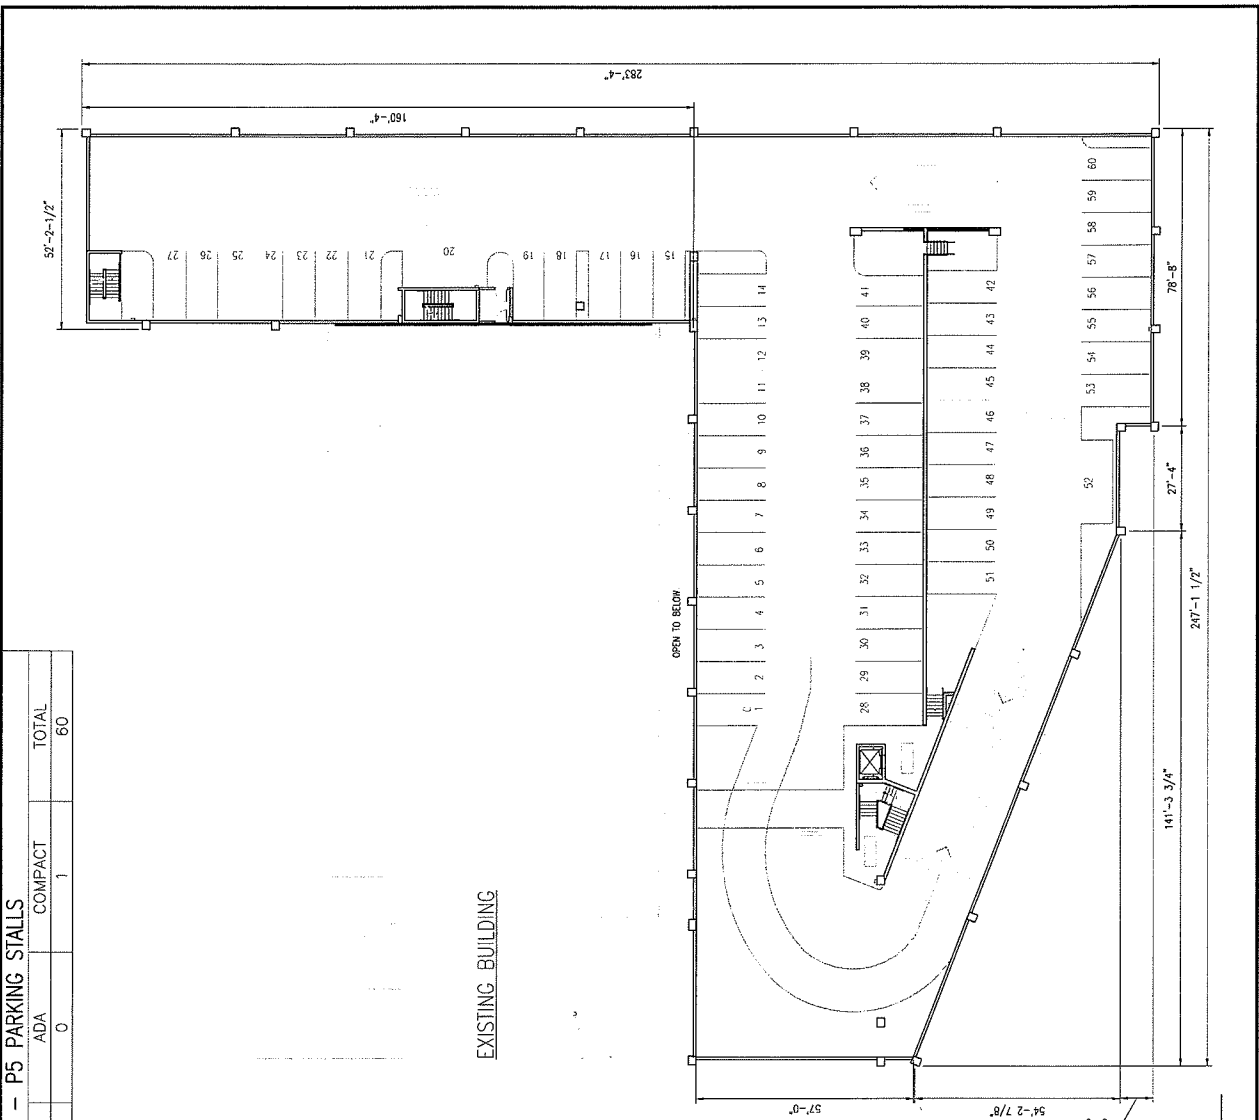

HAWAII ENGINEERING GROUP, Inc.
Civil & Structural Engineers

THIS PROJECT WAS PREPARED BY ME OR UNDER MY SUPERVISION AND I AM A LICENSED PROFESSIONAL ENGINEER. MY LICENSE NO. IS 7828-S. IT WILL BE UNDER MY JURISDICTION.

Exp. Date: 4-30-18

PROJECT:
MARY SAVIO MEDICAL PLAZA AT NEWTOWN
98-1247 KAHUMANU STREET
AIEA, HAWAII 96701

T.M.K.: 9-8-008-026

SHEET TITLE:
EXISTING P4A & P5 FLOOR PLAN

ISSUANCE/REVISIONS

No.	Date	Description
1	05/10/17	Scale AS NOTED
2		Drawn By KLI, AQ
3		Design By AD
4		Checked By AD

Job: 16-162
Sheet: **A-2E**
5 of 10 Sheets

GRAPHIC SCALES:
IF SHEET IS NOT 24"x36"
USE GRAPHIC SCALE


1/8" = 1'-0"

EXISTING P4A & P5 FLOOR PLAN
SCALE: 1/16" = 1'-0"

03/2016 Project/16-162 Mary Savio Medical Plaza (2017) is licensed under the laws of the State of Hawaii. All rights reserved. No part of this document may be reproduced without the prior written permission of HEG.

P6 PARKING STALLS			
STANDARD	ADA	COMPACT	TOTAL
72	0	0	72

TOTAL PARKING	
DESCRIPTION	STALLS
REGULAR PARKING STALL:	394 STALLS
COMPACT PARKING STALL:	4 STALLS
HANDICAP PARKING STALL:	16 STALLS
TOTAL PARKING STALL:	414 STALLS
LOADING STALL:	6 STALLS

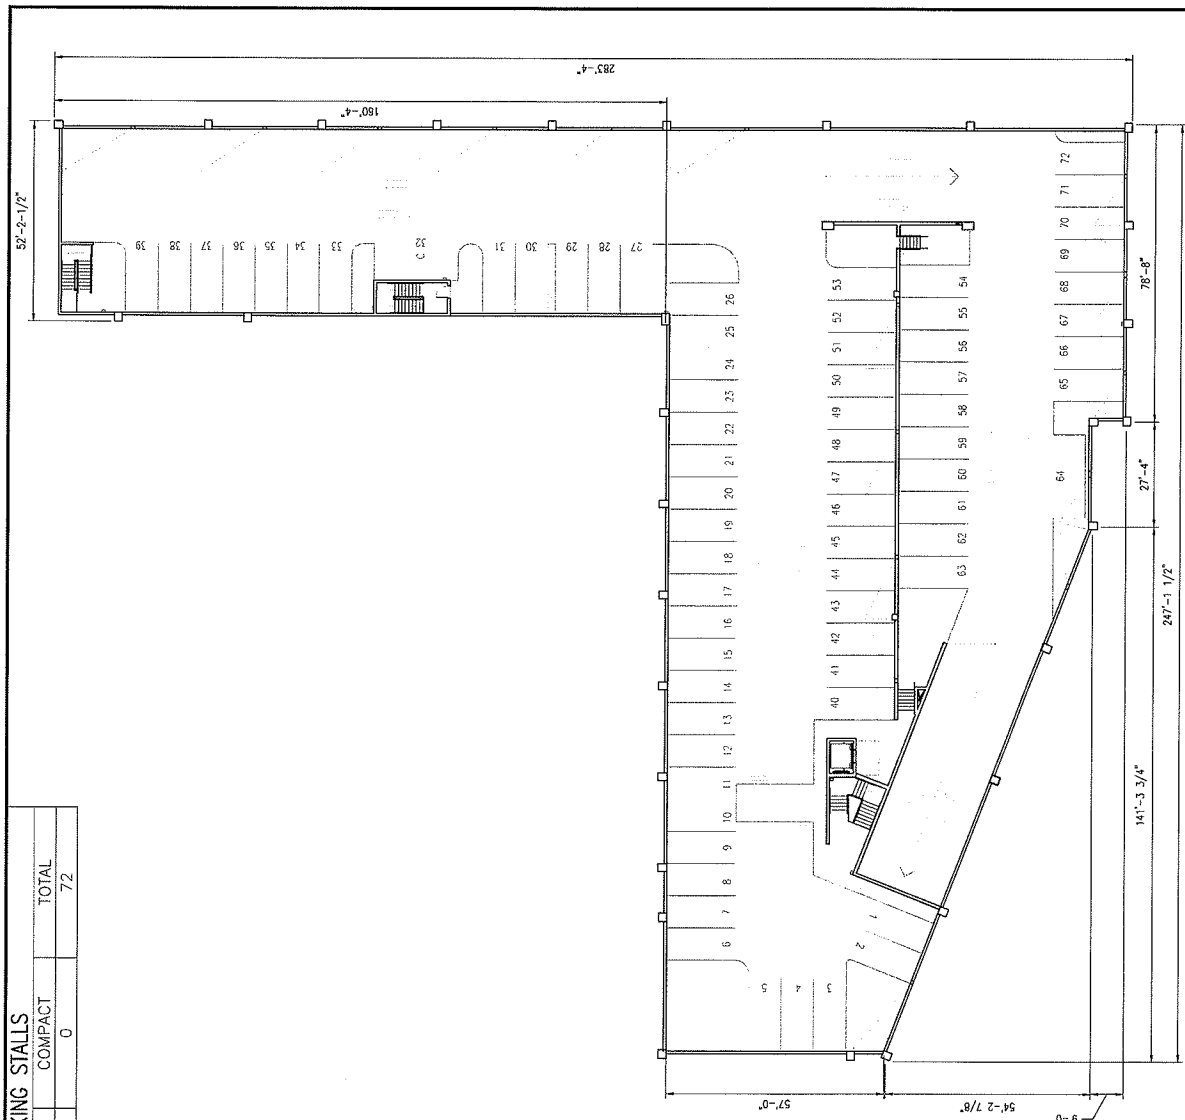

HAWAII ENGINEERING GROUP, Inc.
Civil & Structural Engineers



THIS PROJECT WAS PREPARED BY ME OR UNDER MY SUPERVISION AND I AM A LICENSED PROFESSIONAL ENGINEER. I WILL BE UNDER MY OBSERVATION.

PROJECT
MARY SAVIO MEDICAL PLAZA AT NEWTOWN
CONDOMINIUM MAP
98-1247 KAAHUMANU STREET
ALEA, HAWAII 96701

T.M.K.: 9-8-008-028
SHEET TITLE
EXISTING P6 FLOOR
PLAN

ISSUANCE/REVISIONS

Date	05/10/17
Scale	AS NOTED
Drawn By	KJ, AD
Design By	AD
Checked By	AD

Sheet **A-2F**
6 OF 10 Sheets



GRAPHIC SCALES:
IF SHEET IS NOT 24" x 36"
USE GRAPHIC SCALE




1
A-20
EXISTING P6 PARKING
SCALE: 1/16" = 1'-0"


SQUARE FOOTAGE THIRD FLOOR

MAUKA WING

DESCRIPTION	SQUARE FOOTAGE
1. UNIT 301/303/305	2,041 SQ. FT
2. UNIT 302A	447 SQ. FT

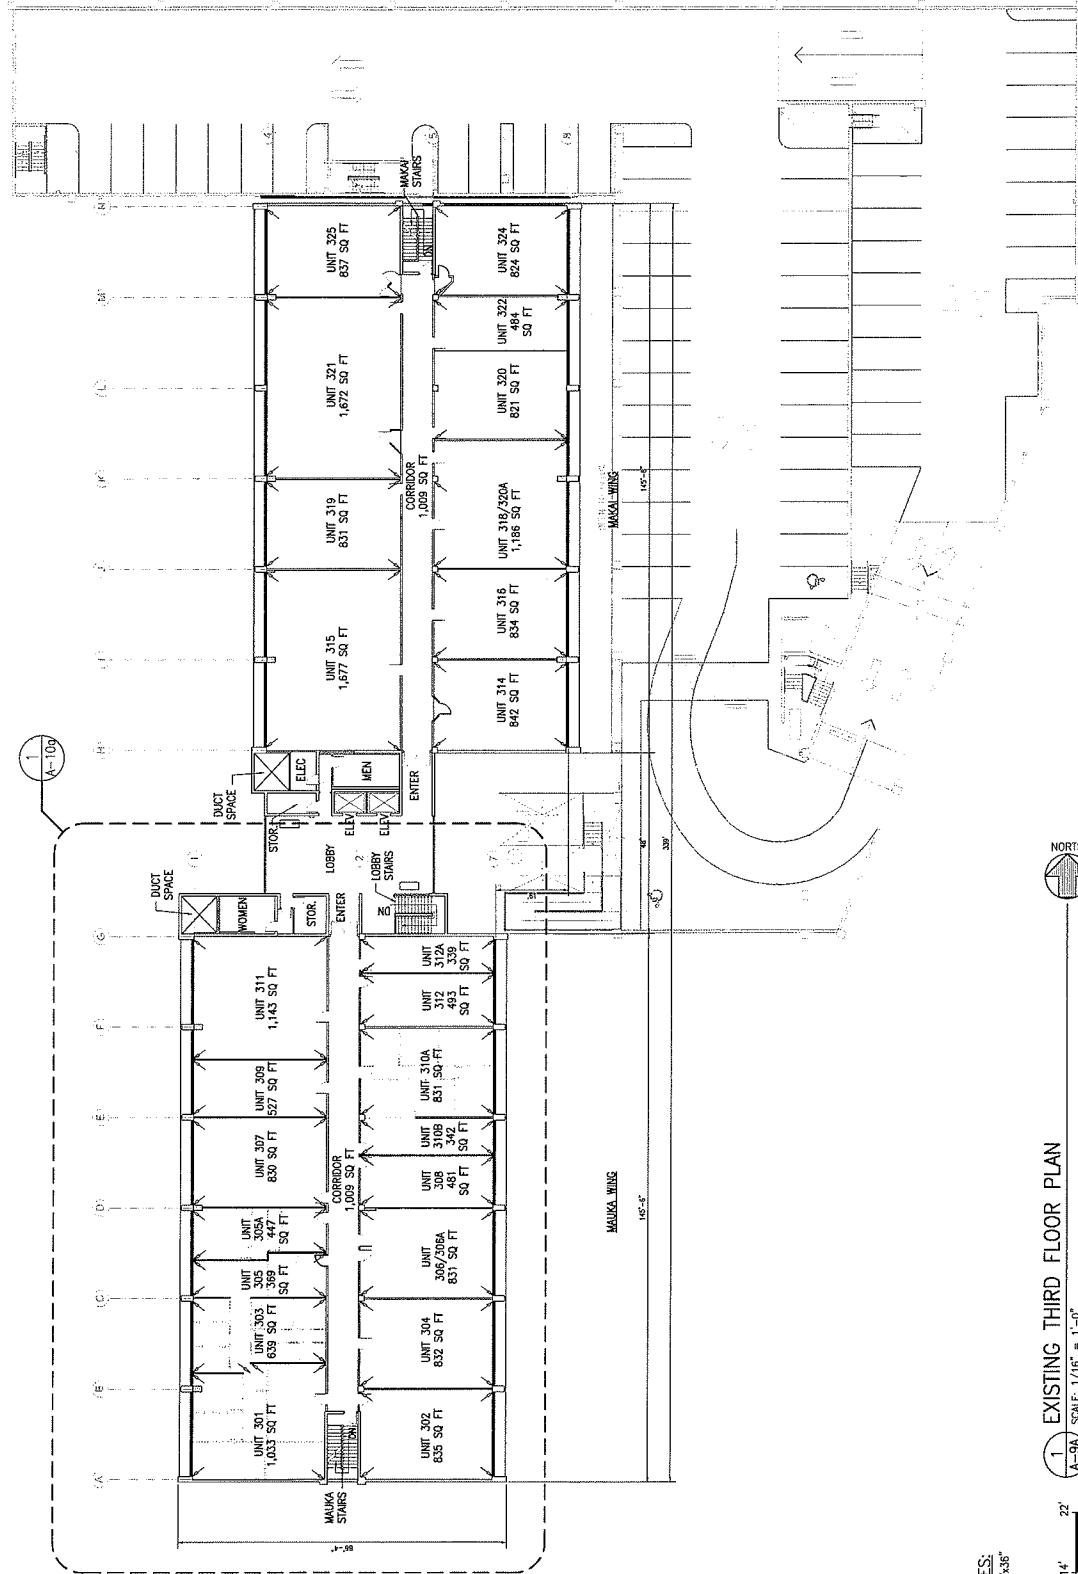

GRAPHIC SCALES:
IF SHEET IS NOT 24"x36"
USE GRAPHIC SCALE

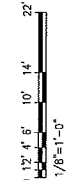

1. EXISTING THIRD FLOOR PLAN
SCALE: 1/16" = 1'-0"
A-9A

HAWAII ENGINEERING GROUP, Inc.
Civil & Structural Engineers

Exp. Date: 4-30-18

THIS PROJECT WAS PREPARED BY ME OR UNDER MY CLOSE PERSONAL SUPERVISION AND CONSTRUCTION OF THIS PROJECT WILL BE UNDER MY OBSERVATION.

PROJECT
MARY SAVIO MEDICAL MAP
CONDOMINIUM MAP
98-1247 KAHUMANU STREET
AIEA, HAWAII 96701

T.M.K.: 9-8-008.026

SUBJECT TITLE
EXISTING THIRD FLOOR PLAN



ISSUANCE/REVISIONS

NO.	DATE	DESCRIPTION
1	05/19/17	DATE AS NOTED
2		DRAWN BY: KJ, AO
3		DESIGN BY: AD
4		CHECKED BY: AD
5		JOB NO: 16-162

Sheet **A-9A**
7 of 10 Sheets

SQUARE FOOTAGE THIRD FLOOR

MAUKA WING	
DESCRIPTION	SQUARE FOOTAGE
1. UNIT 301/303/305	2,041 SQ. FT.
2. UNIT 306A	447 SQ. FT.

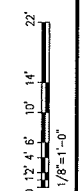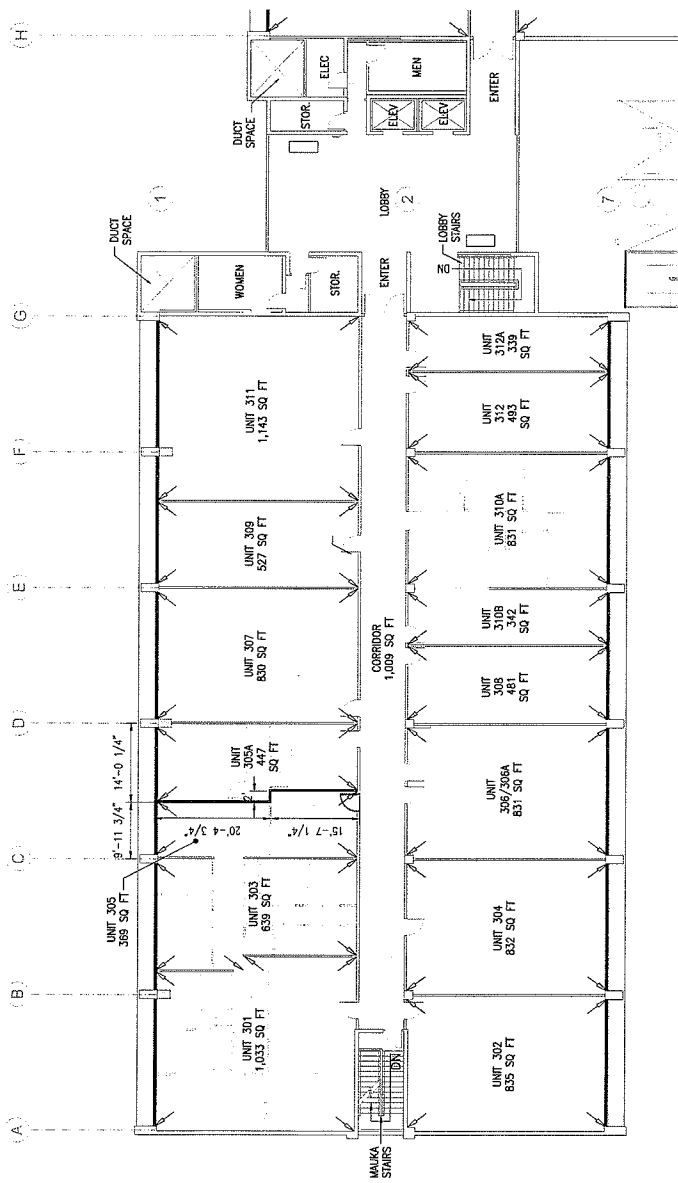

1 ENLARGED MAUKA THIRD FLOOR PLAN
SCALE: 3/32" = 1'-0"



GRAPHIC SCALES:
IF SHEET IS NOT 24"x36"
USE GRAPHIC SCALE

HAWAII ENGINEERING GROUP, Inc.
Civil & Structural Engineers

Exp. Date: 4-30-18

[Signature]

THIS PROJECT WAS PREPARED BY ME OR UNDER MY SUPERVISION AND I AM A LICENSED PROFESSIONAL ENGINEER IN THE STATE OF HAWAII. THIS PROJECT WILL BE UNDER MY OBSERVATION.

PROJECT:
MARY SAVIO MEDICAL PLAZA AT NEWTOWN
CONDOMINIUM MAP
ENLARGED MAUKA
THIRD FLOOR PLAN

T.M.K.: 9-8-008-026
98-1247 KAHUIMANU STREET
AIEA, HAWAII 96701

ISSUANCE/REVISIONS

NO.	DATE	DESCRIPTION
1	05/10/17	Scale AS NOTED
2		Drawn By: KI, AQ
3		Design By: AD
4		Checked By: AD

Job: 16-162

Sheet: **A-10A**

8 OF 10 SHEETS



HAWAII
ENGINEERING
GROUP, Inc.
Civil & Structural Engineers



Exp. Date: 4-25-18

THIS PROJECT WAS PREPARED BY
ME OR UNDER MY SUPERVISION AND
I AM A LICENSED PROFESSIONAL ENGINEER.
IT WILL BE UNDER MY JURISDICTION.


PROJECT
MARY SAVIO MEDICAL PLAZA AT NEWTOWN
CONDOMINIUM MAP
98-1247 KAAHUMANU STREET
AIEA, HAWAII 96701
T.M.K. : 9-8-008-026

SHEET TITLE
EXTERIOR
ELEVATIONS


ISSUANCE/REVISIONS

Date: 05/10/17
Scale: AS NOTED
Drawn By: KJ, AQ
Design By: AD
Checked By: AD
Job: 16-162

Sheet
A-13A
9 OF 10 SHEETS

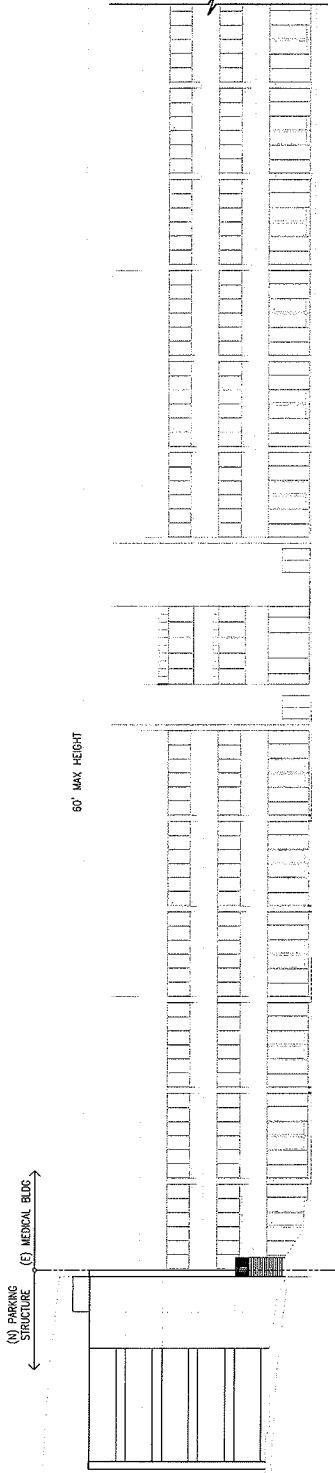


1 WEST ELEVATION
SCALE: 1/16" = 1'-0"

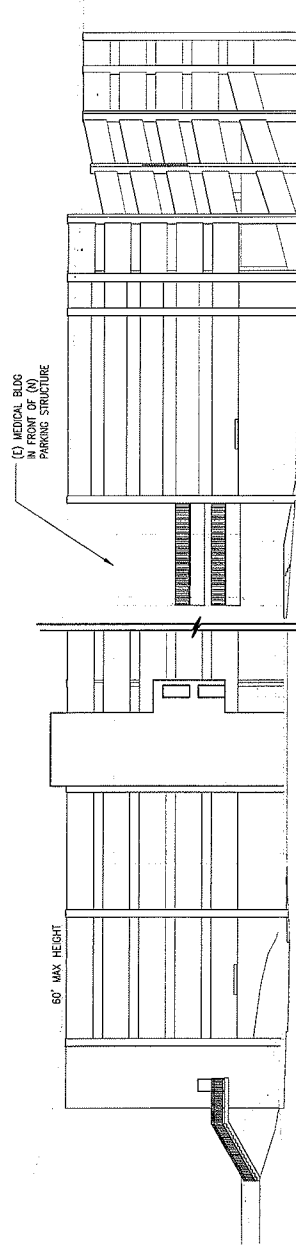

2 SOUTH ELEVATION
SCALE: 1/16" = 1'-0"

GRAPHIC SCALES:
IF SHEET IS NOT 24"x36"
USE GRAPHIC SCALE

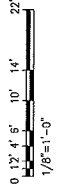




Exp. Date: 4-25-16
 THE PROJECT WAS PREPARED BY ME OR UNDER MY CLOSE PERSONAL SUPERVISION AND I AM A LICENSED PROFESSIONAL ENGINEER IN THE STATE OF HAWAII. THIS PROJECT WILL BE UNDER MY OBSERVATION.

PROJECT: MARY SAVIO MEDICAL PLAZA AT NEWTOWN
 98-1247 KAAHUMANU STREET
 AIEA, HAWAII 96701
 T.M.K.: 9-8-008.026
 SHEET TITLE: EXTERIOR ELEVATIONS

ISSUANCE/REVISIONS
 Date: 05/10/17
 Scale: AS NOTED
 Drawn By: K.J. AD
 Design By: AD
 Checked By: AD
 Job: 16-162

Sheet A-13B
 10 OF 10 SHEETS

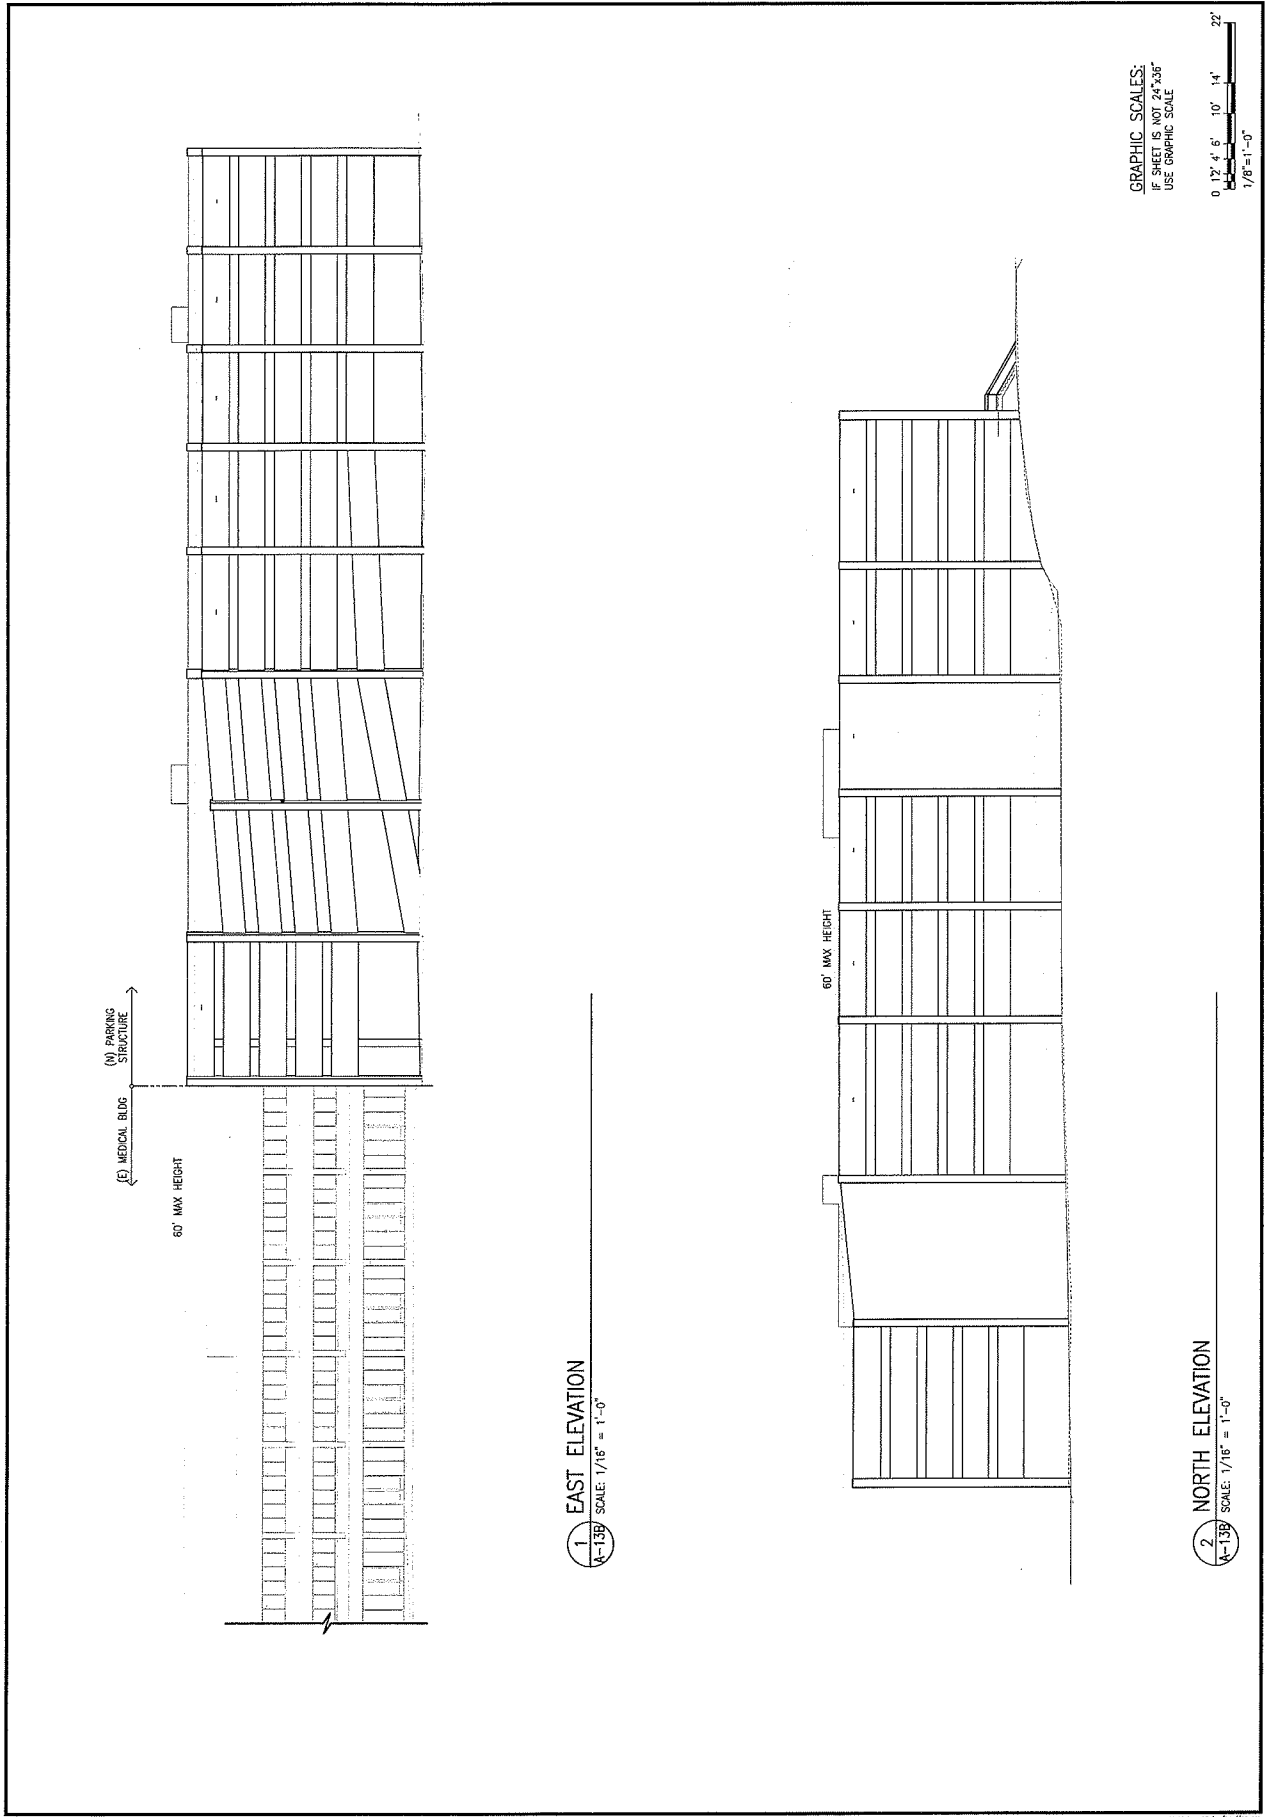

1 EAST ELEVATION
 A-13B SCALE: 1/16" = 1'-0"

2 NORTH ELEVATION
 A-13B SCALE: 1/16" = 1'-0"

GRAPHIC SCALES:
 IF SHEET IS NOT 24"x36"
 USE GRAPHIC SCALE

